




THE MULLER COMPANY

TEL.: 310-316-4290  
FAX: 310-543-2905

LEASED AND MANAGED BY  
THE MULLER COMPANY  
www.torranceexecutiveplaza.com

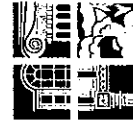

THE  
WREN GROUP  
INCORPORATED  
Architecture & Interiors  
626.564.2650

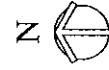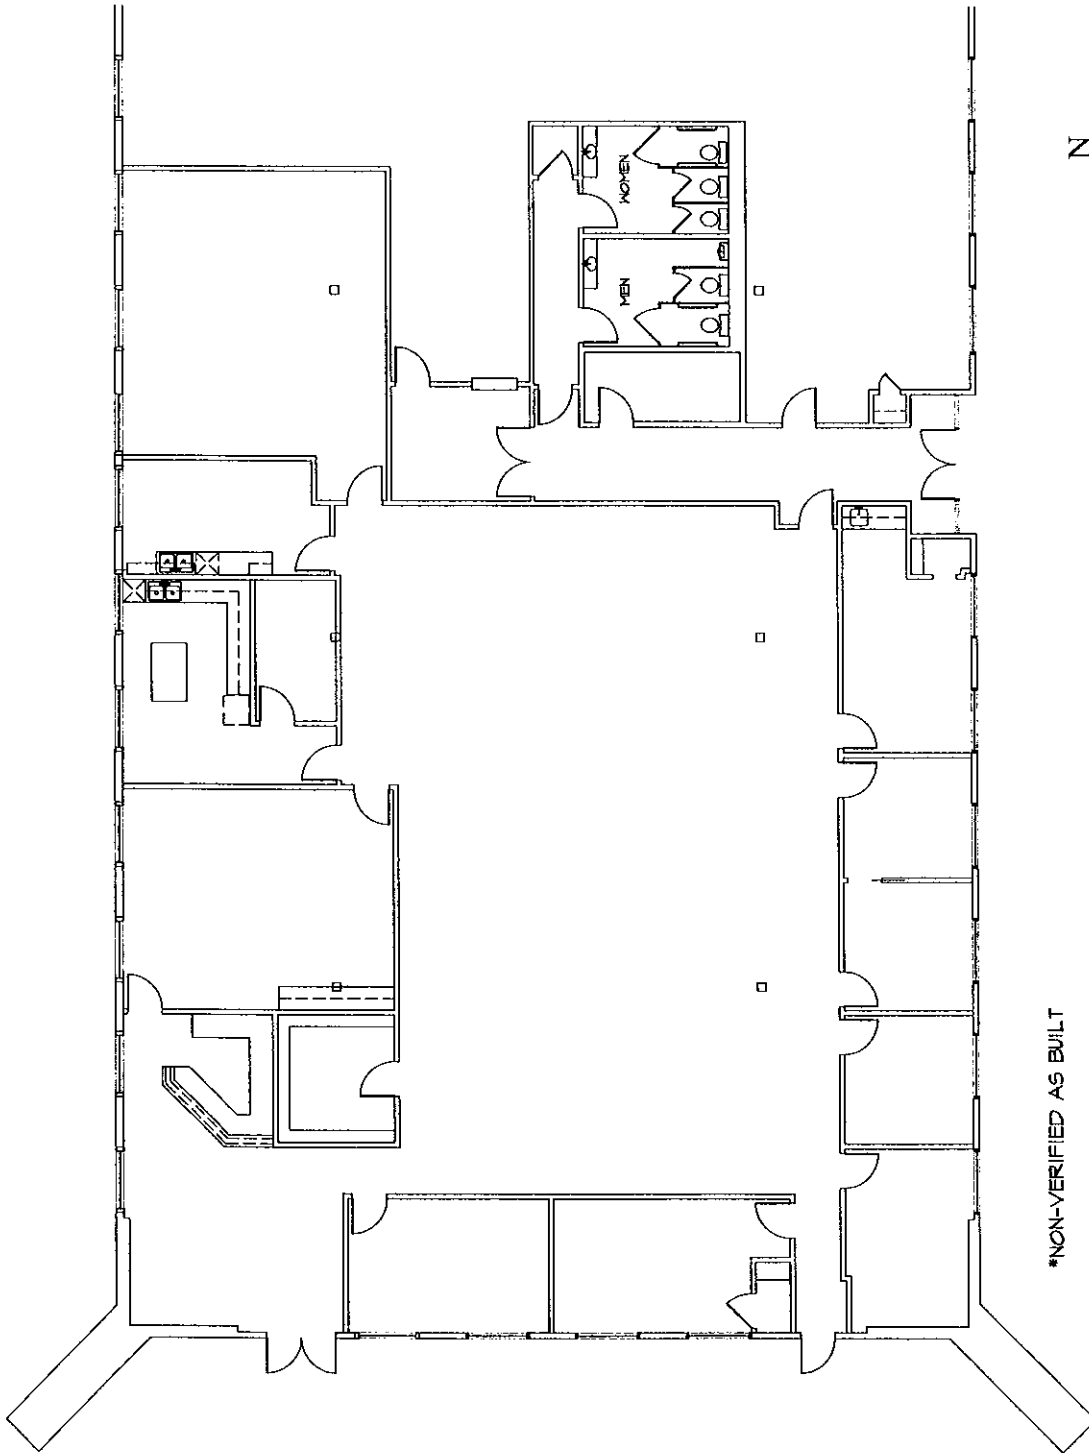

\*NON-VERIFIED AS BUILT

## SUITE 100

SCALE: N.T.S.  
DATE: 07-17-09  
RSF: 6,138

Torrance Executive Plaza East

3440 Torrance Blvd. Torrance, CA 90503