


3480 Torrance Boulevard,
Suite 226

RSF: 1,873

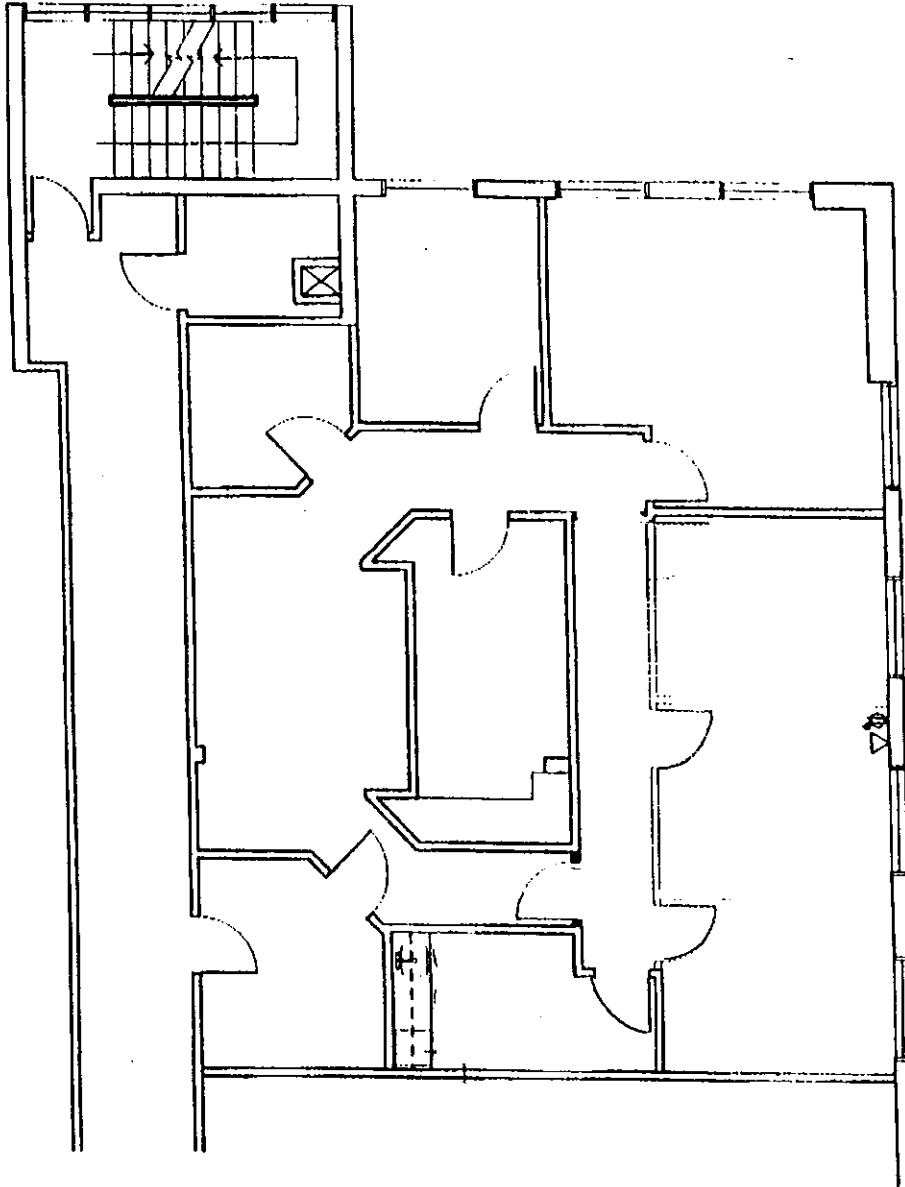

tenant		date	4.8.97
address	3480 Torrance Blvd. Ste. 226 Torrance, CA 90503	scale	1/8" = 1'-
		job	301.196

square feet:	rentable	approved by:	
revisions	4-14-97	date	w/chgs <input type="checkbox"/> w/o chgs

THE WREN GROUP

44 West Bellevue Drive, Suite 6 Pasadena, CA 91105

818.564.2650

Fax 818. 564.