

TEL.: 310-316-4290
FAX: 310-543-2905

LEASED AND MANAGED BY
THE MULLER COMPANY
www.torranceccxexecutiveplaza.com


SUITE: 301-302

SCALE: N.T.S.


PROPOSED: 8.24.05
REVISED: 9.09.05



THE
WREN GROUP
INCORPORATED
Architecture & Interiors
(626)564-2650

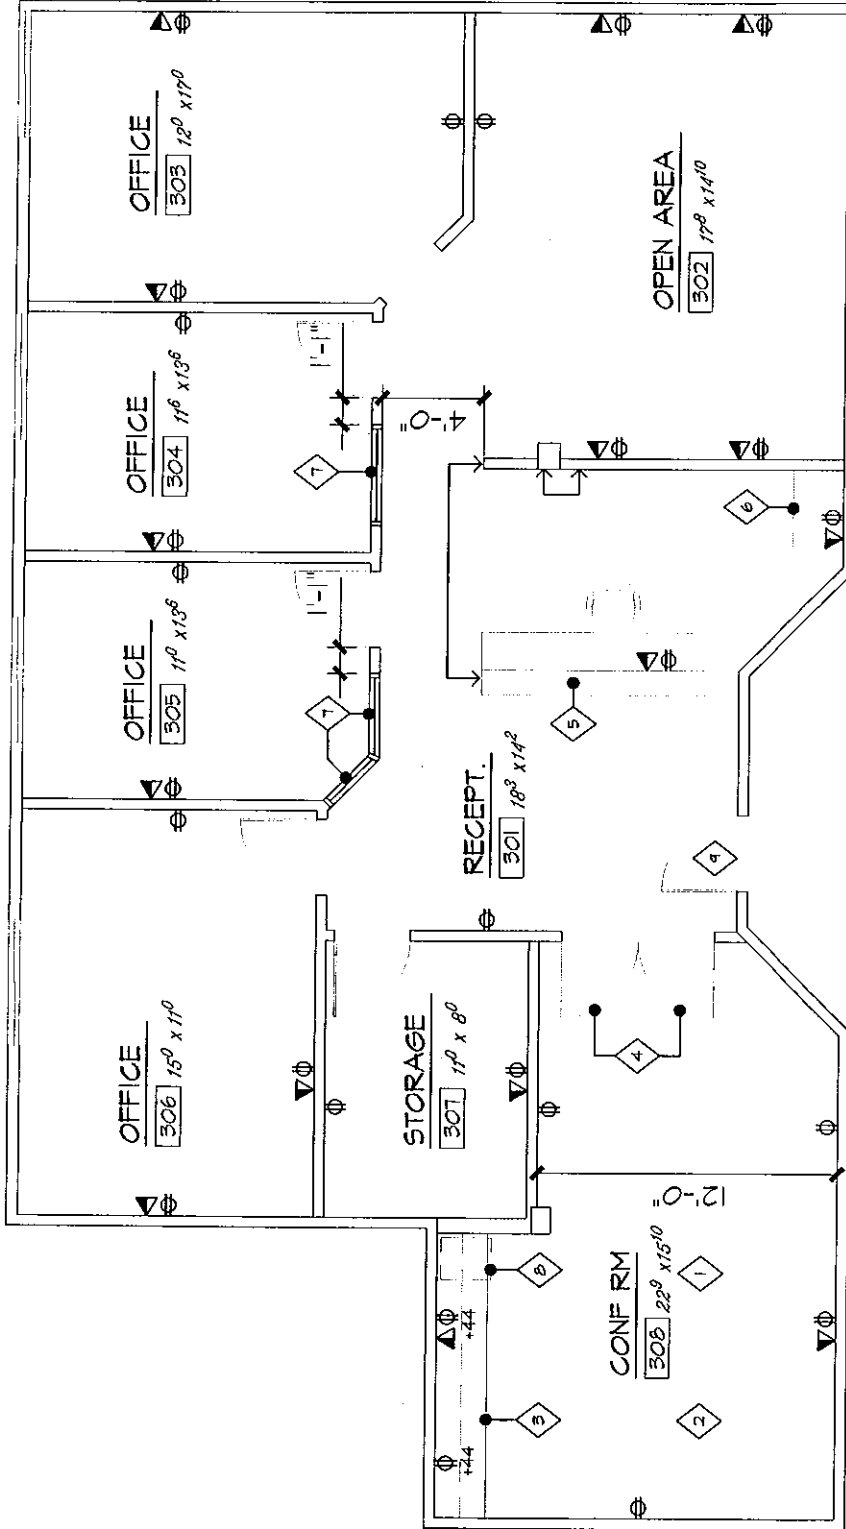

NOTE: NOT VERIFIED AS-BUILT

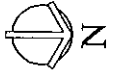

Torrance Executive Plaza
3510 Torrance Blvd Torrance, California