

THE MULLER COMPANY


TEL: 310-316-4290
FAX: 310-543-2905

LEASED AND MANAGED BY
THE MULLER COMPANY
www.torranceexecutiveplaza.com



THE WREN GROUP
INCORPORATED
Architecture & Interiors
628.564.2680

SEP 25 2008

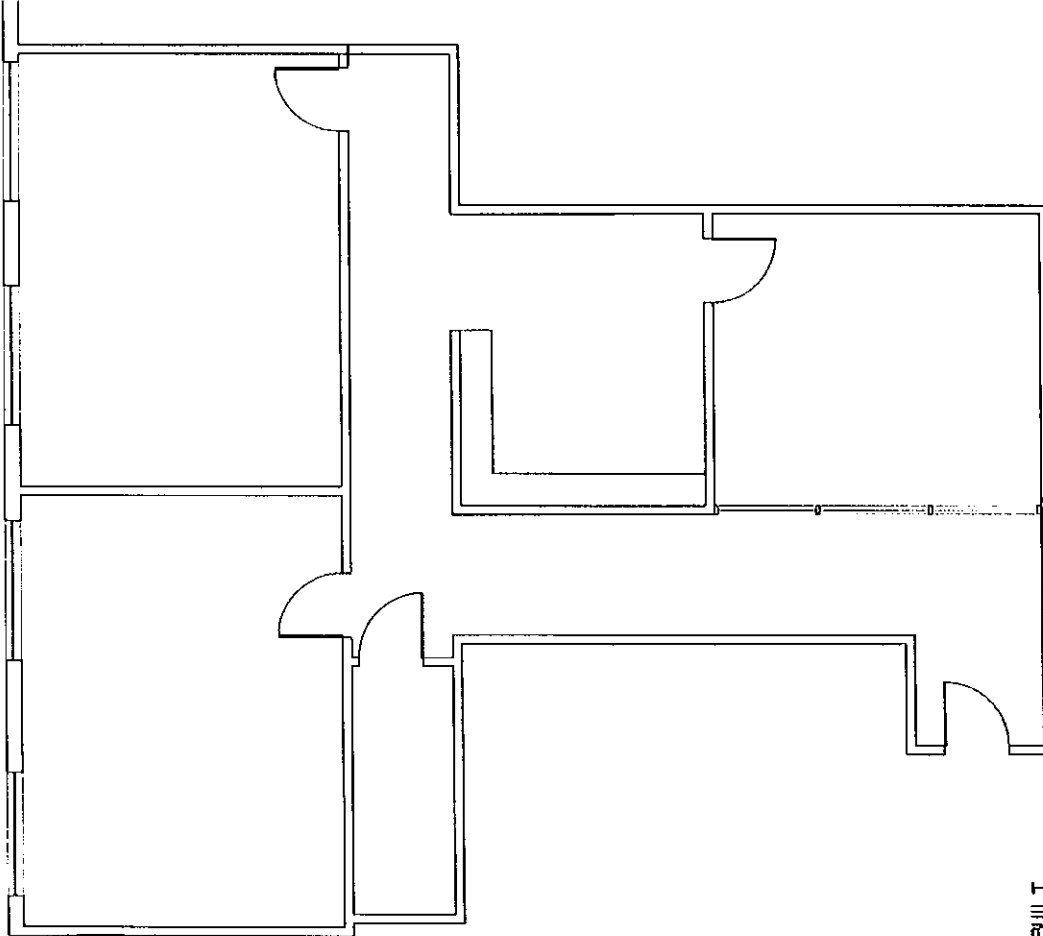

SUITE 210

SCALE: 1/8" = 1'-0"
DATE: 09-26-08
RSF: 1,259

*NON-VERIFIED AS BUILT

Torrance Executive Plaza

3838 Carson St. Torrance, CA 90503