


Torrance Executive Plaza

3510 Torrance Blvd. Torrance, CA 90503

SUITE 100

SCALE: 1/8"=1'-0"
DATE: 07-02-09

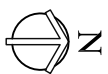

theMullercompany

TEL: 310-316-4290
FAX: 310-543-2905

LEASED AND MANAGED BY
THE MULLER COMPANY
www.torranceexecutiveplaza.com



THE WREN GROUP
INCORPORATED
Architecture & Interiors
626-564-2650