


**Torrance Executive Plaza**  
 3510 Torrance Blvd Torrance, California

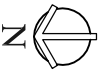

**theMullercompany**  
 SANDRA BUTLER  
 TEL: 310-316-4290  
 FAX: 310-543-2905  
 LEASED AND MANAGED BY  
 THE MULLER COMPANY  
[www.torranceexecutiveplaza.com](http://www.torranceexecutiveplaza.com)

**SUITE: 303**  
**R.S.F. 995**

**SCALE: 1/8" = 1'-0"**

**REVISED: 5.29.02**

**THE WREN GROUP**  
 INCORPORATED  
 Architecture & Interiors  
 (626)564-2650